




LOCATION PLAN

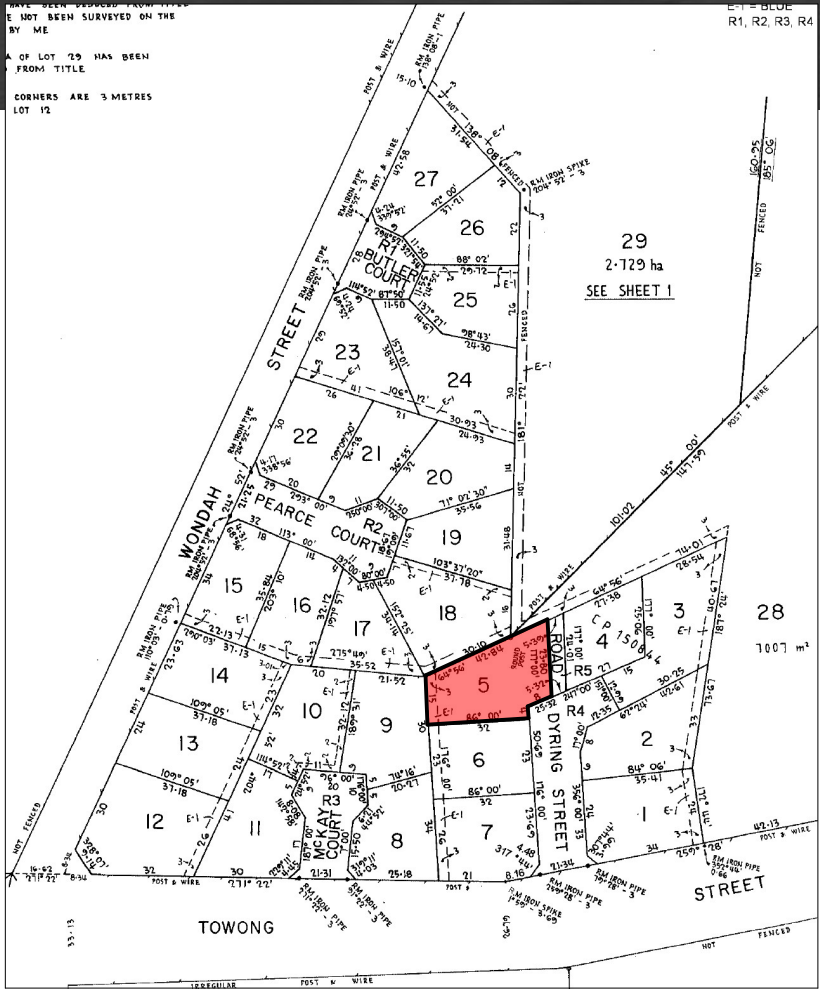

CLIENT: **Ian Chivers & Melinda Chivers**

ADDRESS: **Lot 5 (3) Dyring St.
Tallangatta (VIC) LP130168**



TITLE: **COVER PAGE**

HOUSE TYPE: **CUSTOM** FACADE: **DESIGNER**

PROJECT: **PROPOSED BRICK VENEER DWELLING**

REVISION SCHEDULE		
ISSUE	DATE	DESCRIPTION
A	4.7.25	CC/DA ISSUE
B	1.9.25	CR-02
C	10.09.25	CR-03
D	29.09.25	BAL NOTES
E	8.10.25	LPOD NOTE ADDED
-	-	-

Sheet	Drawing	Drawing Issue	NOTES:
01	COVER PAGE	-	* REFER TO ENGINEERS DETAILS FOR ALL EXPANSION JOINT LOCATIONS.
02	SURVEY	-	* REFER TO ENGINEERS DETAILS FOR ALL STEEL BEAM AND FLOOR JOIST LOCATIONS AND DIRECTIONS.
03	SITE PLAN	-	* REFER TO TRUSS MANUFACTURERS DETAILS FOR ALL FLOOR JOIST SIZES AND DIRECTIONS.
04	CONCEPT DRAINAGE PLAN	-	* REFER TO A/C DETAILS FOR A/C DUCT POSITIONS.
05	LANDSCAPE	-	* A/C DUCT LOCATIONS MAY NEED TO CHANGE DUE TO CONSTRUCTION REQUIREMENTS (JOIST LOCATION, STRUCTURAL BEAMS ETC).
06	GROUND FLOOR PLAN	-	* FLOOR FINISHES AS SELECTED AS PER TENDER.
07	ELEVATIONS	-	* STAIRS TO MEET THE MINIMUM SLIP RESISTANCE REQUIREMENT OF PART 11.2.4 OF NCC 2022 WHEN TESTED IN ACCORDANCE WITH AS4586-2013
08	ELEVATIONS	-	* FLOOR COVERINGS WILL ACHIEVE A MINIMUM SLIP RESISTANCE CLASSIFICATION OF P4 IN ACCORDANCE WITH AS4586 AND NCC 2022
09	SECTIONS	-	* FIRST FLOOR WINDOWS TO BE RESTRICTED TO OPEN A MAX. OF 125mm IF SILL HEIGHT IS LOWER THAN 1700mm ABOVE A FLOOR LEVEL.
10	CONCRETE LAYOUT	-	* HANDRAILS TO STAIRS IN ACCORDANCE WITH NCC 2022 PART 11.3.5
11	TYPICAL ELECTRICAL PLAN	-	* NOTES: BOUNDARY SETBACKS MUST BE VERIFIED BY A REGISTERED SURVEYOR BEFORE COMMENCEMENT OF ANY BUILDING WORK. LEVELS SHOWN ARE BASED ON CONTOUR SURVEY PREPARED BY A REGISTERED SURVEYOR
12	REINFORCEMENT WALLS	-	* ALL WORK TO BE CARRIED OUT IN ACCORDANCE WITH THESE DRAWINGS, COUNCIL REQUIREMENTS, RELEVANT CODES & STANDARDS. DRAWINGS ARE TO BE READ IN CONJUNCTION WITH SPECIFICATIONS PROVIDED.
13	STANDARD DETAILS	-	* ENGINEERS DETAILS, WHERE ENGINEERS STRUCTURAL DRAWINGS ARE REQUIRED THE ENGINEERS PLAN WILL TAKE PREFERENCE TO THESE DRAWINGS. IN THE EVENT OF ANY ALTERATIONS OR DISCREPANCIES, NOTIFY THE BUILDER IMMEDIATELY. FIGURED DIMENSIONS TO BE READ IN PREFERENCE TO SCALING & TO BE CHECKED & VERIFIED BEFORE WORK IS COMMENCED.

DRAWING ISSUE:	E	COUNCIL:	TOWONG
DRAWN BY:	RA	SHEET:	01
SCALE:	1:1, 1:100		

NOTES:



- METERBOX & GAS METER LOCATION TO BE DETERMINED ON SITE.
- HOT WATER SYSTEM & MANHOLE LOCATION MAY REQUIRE RELOCATION DUE TO CONSTRUCTION CONSTRAINTS
- DOOR FRAME OPENINGS TO BE 90mm CLEAR OF WALL TO ALLOW FOR LARGER ARCHITRAVES
- DO NOT SCALE OFF DRAWINGS. USE WRITTEN DIMENSIONS
- 90x35 TIMBER STUD FRAMING TO GROUND & FIRST FLOOR
- ALL FRAMES & TRUSSES WILL BE SUPPLIED AS PREFABRICATED AND CONSTRUCTED IN ACCORDANCE WITH THE MANUFACTURERS ENGINEERING CALCULATIONS
- TIMBER FLOOR JOIST TO MANUFACTURERS SPECIFICATION
- REINFORCED CONCRETE SLAB TO ENGINEERS DETAILS
- WINDOW FRAMES GLAZING & ASSOCIATED MATERIALS SHOULD BE TO MANUFACTURERES SPECIFICATIONS. MANUFACTURER TO CERTIFY DESIGN COMPLAINTCE WITH NCC 11.3.7 & APPLICABLE TO AUSTRALIAN STANDARDS
- ALL INTERNAL DIMENSIONS EXCLUDE THICKNESS OF PLASTERBOARD AND ARE NOMINAL
- **CONSTRUCTION IN ACCORDANCE WITH NCC2022 & AUSTRALIAN STANDARDS**
- **WATERPROOFING IN ACCORDANCE WITH NCC2022.**

NOTE:

NEW CONSTRUCTION SHALL COMPLY WITH SECTION 5 (BAL 12.5) AUSTRALIAN STANDARD AS 3959-2018 'CONSTRUCTION OF BUILDINGS IN BUSH FIRE-PRONE AREA' & SECTION A3.7 ADDENDUM APPENDIX 3 OF 'PLANNING FOR BUSH FIRE-PROTECTION'.

BAL 12.5 CONSTRUCTION BUSHFIRE REQUIREMENTS

- GRADE-A SAFETY GLASS MIN 4mm THICK GLAZING TO WINDOWS AS NOTED
- SOLID CONSTRUCTION EXTERNAL DOORS AS NOTED
- EXTERNAL DOORS TO HAVE DRAUGHT EXCLUDERS
- FLYSCREENS WITH ALUMINIUM MESH (MAX 2mm APERTURE) TO ALL WINDOW OPENINGS, EXCLUDING GARAGE
- MEDIUM' GRADE SARKING TO UNDERSIDE OF ROOF TILES
- WEEPA WEEP HOLE WITH STAINLESS STEEL SPARK ARRESTOR GRATES & SQUARE VENT SPARK ARRESTORS
- BUSHFIRE TRIM KIT TO SUIT PANELIFT DOOR

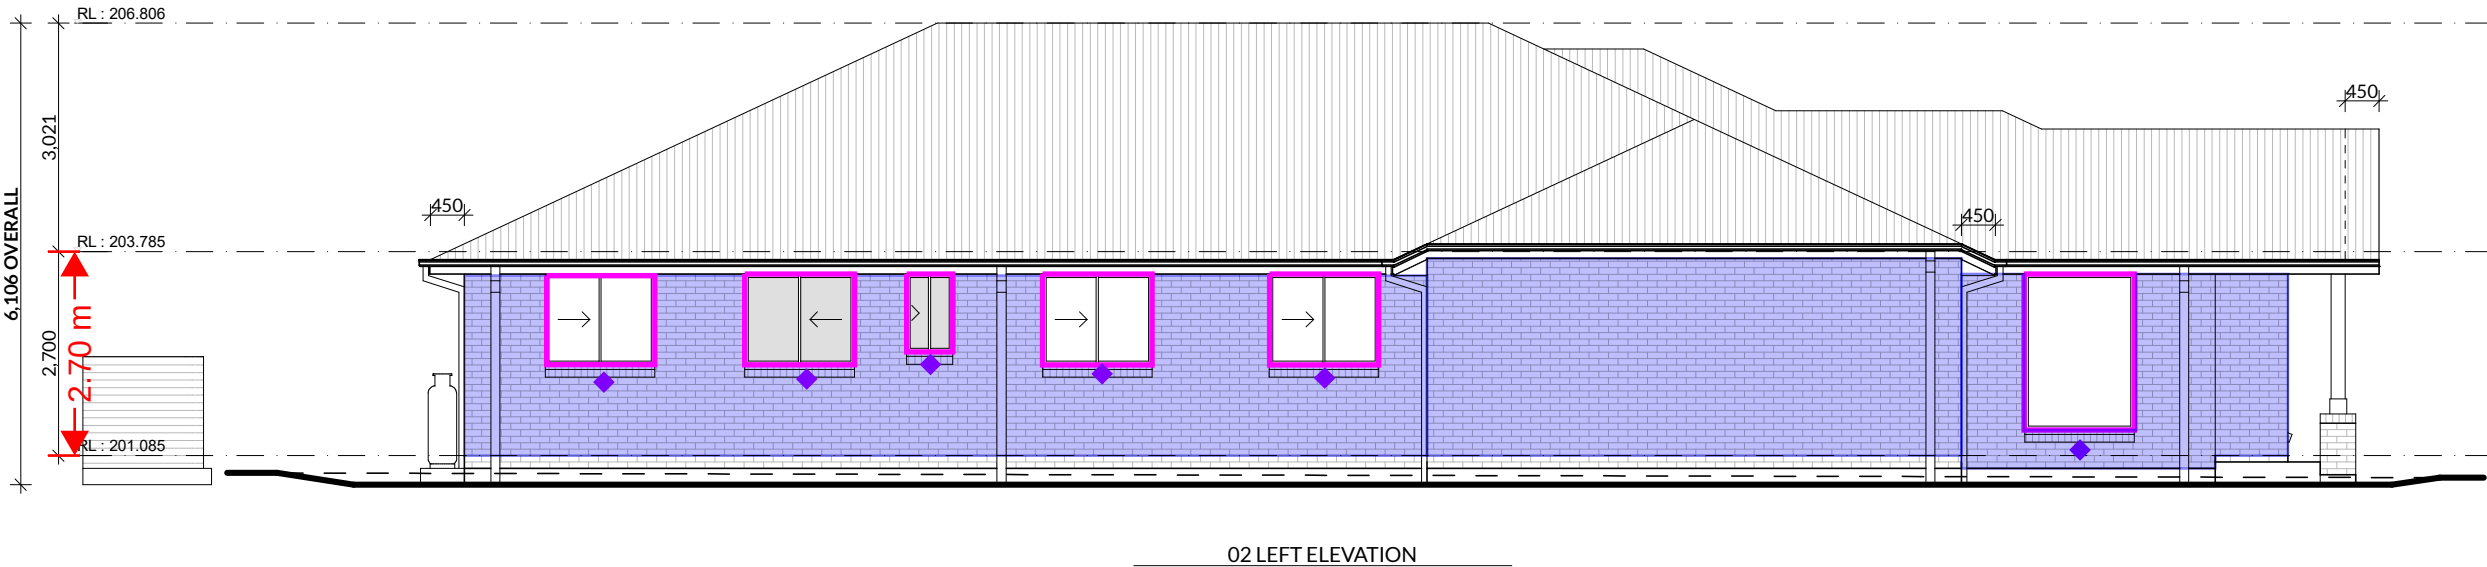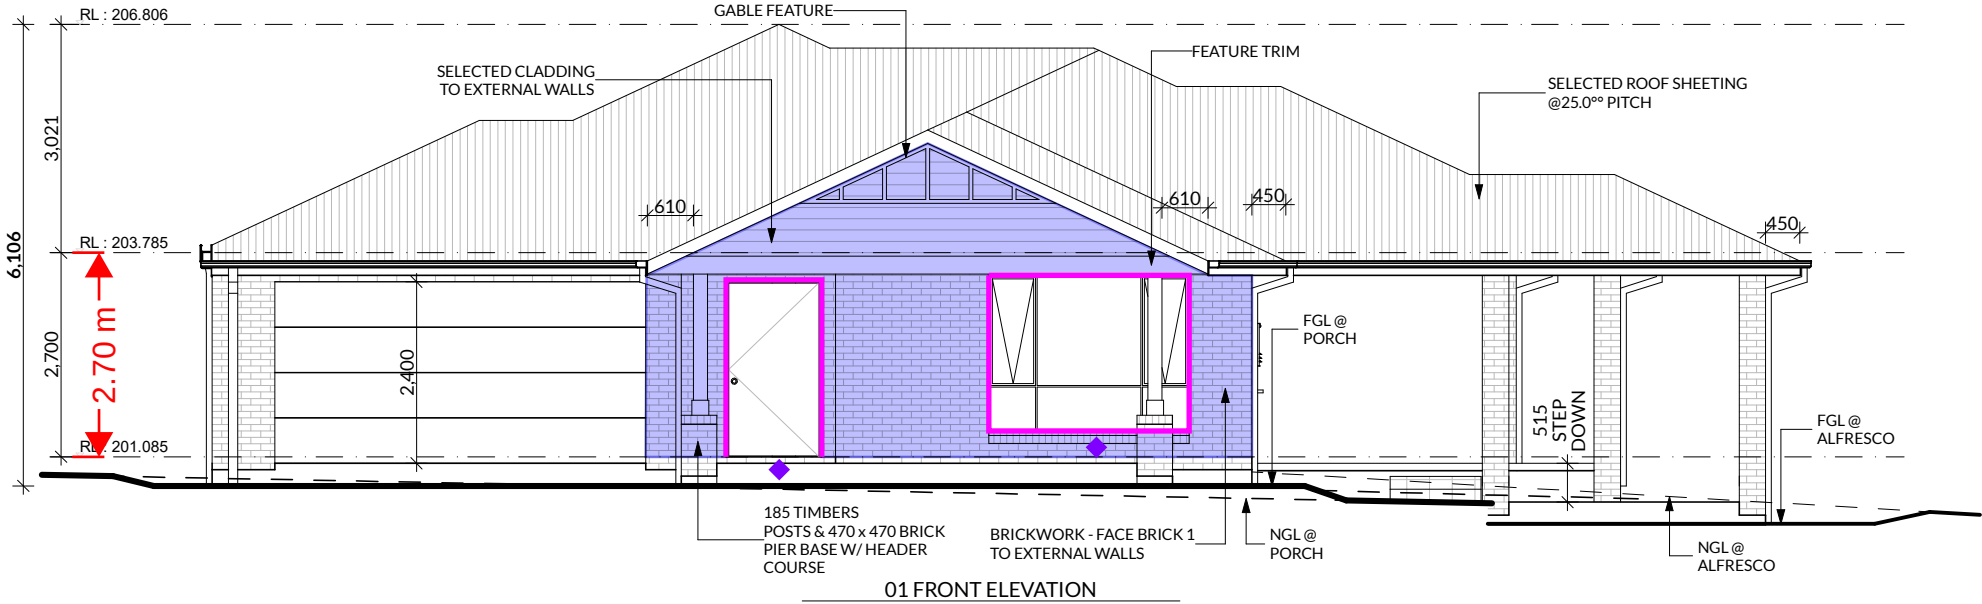

NOTES:

- * REFER TO ENGINEERS DETAILS FOR ALL EXPANSION JOINT LOCATIONS.
- * REFER TO ENGINEERS DETAILS FOR ALL STEEL BEAM AND FLOOR JOIST LOCATIONS AND DIRECTIONS.
- * REFER TO TRUSS MANUFACTURERS DETAILS FOR ALL FLOOR JOIST SIZES AND DIRECTIONS.
- * REFER TO A/C DETAILS FOR A/C DUCT POSITIONS.
- * A/C DUCT LOCATIONS MAY NEED TO CHANGE DUE TO CONSTRUCTION REQUIREMENTS (JOIST LOCATION, STRUCTURAL BEAMS ETC).
- * FLOOR FINISHES AS SELECTED AS PER TENDER.
- * STAIRS TO MEET THE MINIMUM SLIP RESISTANCE REQUIREMENT OF PART 11.2.4 of NCC 2022 WHEN TESTED IN ACCORDANCE WITH AS4586-2013
- * FLOOR COVERINGS WILL ACHIEVE A MINIMUM SLIP RESISTANCE CLASSIFICATION OF P4 IN ACCORDANCE WITH AS4586 AND NCC 2022
- * FIRST FLOOR WINDOWS TO BE RESTRICTED TO OPEN A MAX. OF 125mm IF SILL HEIGHT IS LOWER THAN 1700mm ABOVE A FLOOR LEVEL.
- * HANDRAILS TO STAIRS IN ACCORDANCE WITH NCC 2022 PART 11.3.5
- * NOTES: BOUNDARY SETBACKS MUST BE VERIFIED BY A REGISTERED SURVEYOR BEFORE COMMENCEMENT OF ANY BUILDING WORK. LEVELS SHOWN ARE BASED ON CONTOUR SURVEY PREPARED BY A REGISTERED SURVEYOR
- * ALL WORK TO BE CARRIED OUT IN ACCORDANCE WITH THESE DRAWINGS, COUNCIL REQUIREMENTS, RELEVANT CODES & STANDARDS. DRAWINGS ARE TO BE READ IN CONJUNCTION WITH SPECIFICATIONS PROVIDED.
- * ENGINEERS DETAILS, WHERE ENGINEERS STRUCTURAL DRAWINGS ARE REQUIRED THE ENGINEERS PLAN WILL TAKE PREFERENCE TO THESE DRAWINGS. IN THE EVENT OF ANY ALTERATIONS OR DISCREPANCIES, NOTIFY THE BUILDER IMMEDIATELY. FIGURED DIMENSIONS TO BE READ IN PREFERENCE TO SCALING & TO BE CHECKED & VERIFIED BEFORE WORK IS COMMENCED.
- * ALL SMOKE ALARMS TO BE IN ACCORDANCE WITH PART 9.5 OF NCC 2022
- * THESE PLANS ARE NOT WORKSHOP DETAILED DRAWINGS AND THEY DO NOT SHOW ALL ELEMENTS, FIXTURES, FITTINGS AND DETAIL AS THEY WILL APPEAR ON SITE ONCE BUILT. THERE WILL BE FIXTURES AND FITTINGS FOR MATERIALS USED ON SITE THAT WILL BE VISIBLE AND FORM PART OF THE HOME BUILT THAT CAN'T BE SHOWN ON THESE ARCHITECTURAL PLANS



REVISION SCHEDULE		
ISSUE	DATE	DESCRIPTION
A	4.7.25	CC/DA ISSUE
B	1.9.25	CR-02
C	10.09.25	CR-03
D	29.09.25	BAL NOTES
E	8.10.25	LP0D NOTE ADDED
-	-	-

NOTES:



- METERBOX & GAS METER LOCATION TO BE DETERMINED ON SITE.
- HOT WATER SYSTEM & MANHOLE LOCATION MAY REQUIRE RELOCATION DUE TO CONSTRUCTION CONSTRAINTS
- DOOR FRAME OPENINGS TO BE 90mm CLEAR OF WALL TO ALLOW FOR LARGER ARCHITRAVES
- DO NOT SCALE OFF DRAWINGS. USE WRITTEN DIMENSIONS
- 90x35 TIMBER STUD FRAMING TO GROUND & FIRST FLOOR
- ALL FRAMES & TRUSSES WILL BE SUPPLIED AS PREFABRICATED AND CONSTRUCTED IN ACCORDANCE WITH THE MANUFACTURERS ENGINEERING CALCULATIONS
- TIMBER FLOOR JOIST TO MANUFACTURERS SPECIFICATION
- REINFORCED CONCRETE SLAB TO ENGINEERS DETAILS
- WINDOW FRAMES GLAZING & ASSOCIATED MATERIALS SHOULD BE TO MANUFACTURERES SPECIFICATIONS. MANUFACTURER TO CERTIFY DESIGN COMPLAINTCE WITH NCC 11.3.7 & APPLICABLE TO AUSTRALIAN STANDARDS
- ALL INTERNAL DIMENSIONS EXCLUDE THICKNESS OF PLASTERBOARD AND ARE NOMINAL
- **CONSTRUCTION IN ACCORDANCE WITH NCC2022 & AUSTRALIAN STANDARDS**
- **WATERPROOFING IN ACCORDANCE WITH NCC2022.**

NOTE:

NEW CONSTRUCTION SHALL COMPLY WITH SECTION 5 (BAL 12.5) AUSTRALIAN STANDARD AS 3959-2018 'CONSTRUCTION OF BUILDINGS IN BUSH FIRE-PRONE AREA' & SECTION A3.7 ADDENDUM APPENDIX 3 OF 'PLANNING FOR BUSH FIRE-PROTECTION'.

BAL 12.5 CONSTRUCTION BUSHFIRE REQUIREMENTS

- GRADE-A SAFETY GLASS MIN 4mm THICK GLAZING TO WINDOWS AS NOTED
- SOLID CONSTRUCTION EXTERNAL DOORS AS NOTED
- EXTERNAL DOORS TO HAVE DRAUGHT EXCLUDERS
- FLYSCREENS WITH ALUMINIUM MESH (MAX 2mm APERTURE) TO ALL WINDOW OPENINGS, EXCLUDING GARAGE
- MEDIUM' GRADE SARKING TO UNDERSIDE OF ROOF TILES
- WEEPA WEEP HOLE WITH STAINLESS STEEL SPARK ARRESTOR GRATES & SQUARE VENT SPARK ARRESTORS
- BUSHFIRE TRIM KIT TO SUIT PANELIFT DOOR

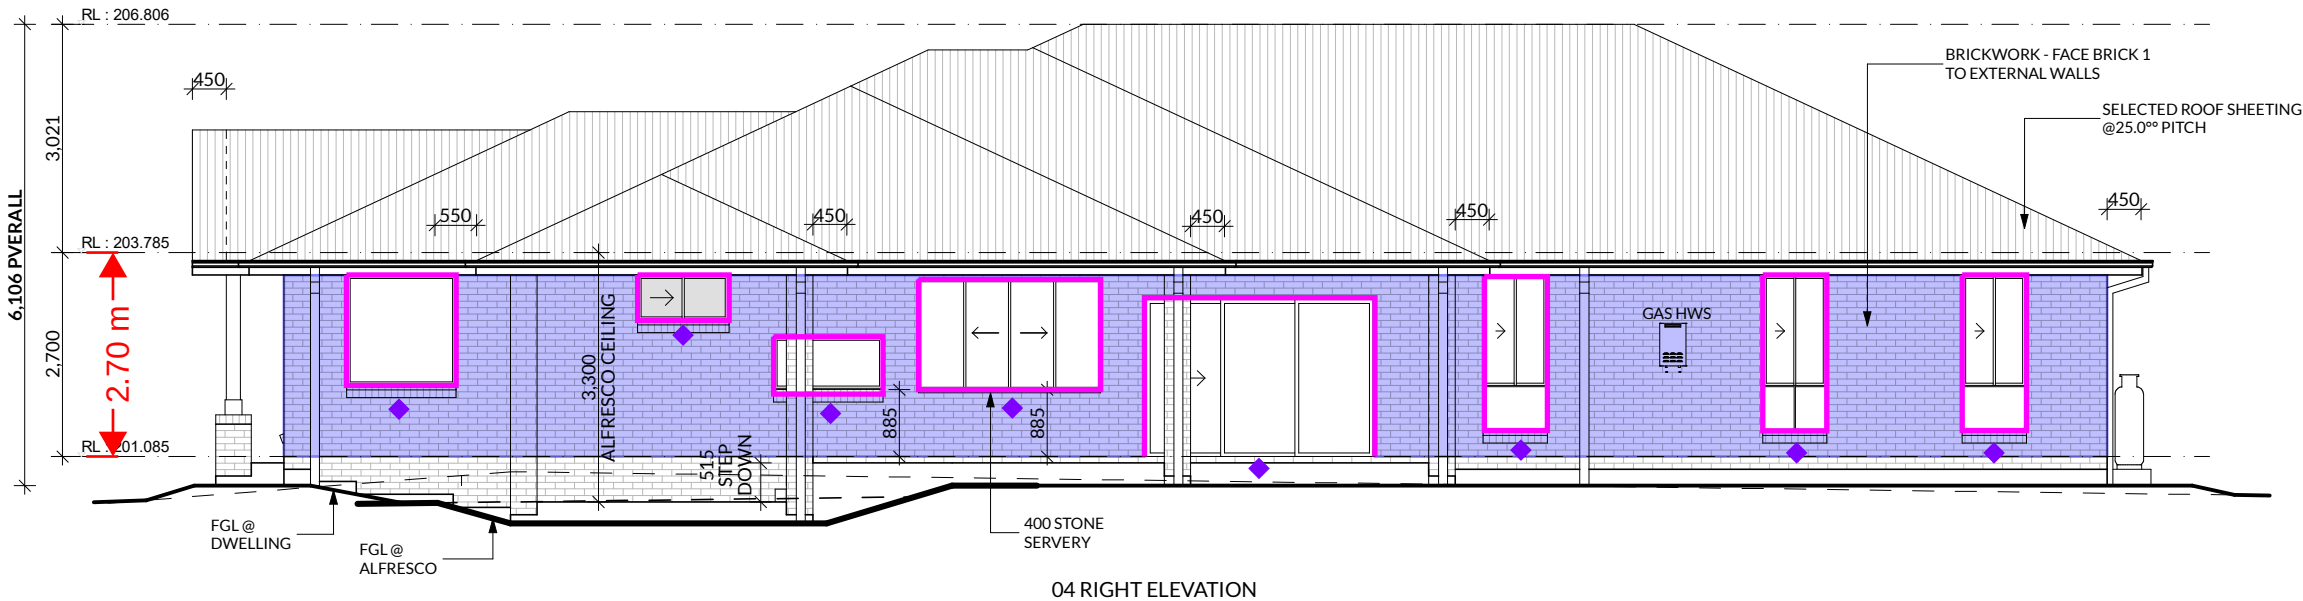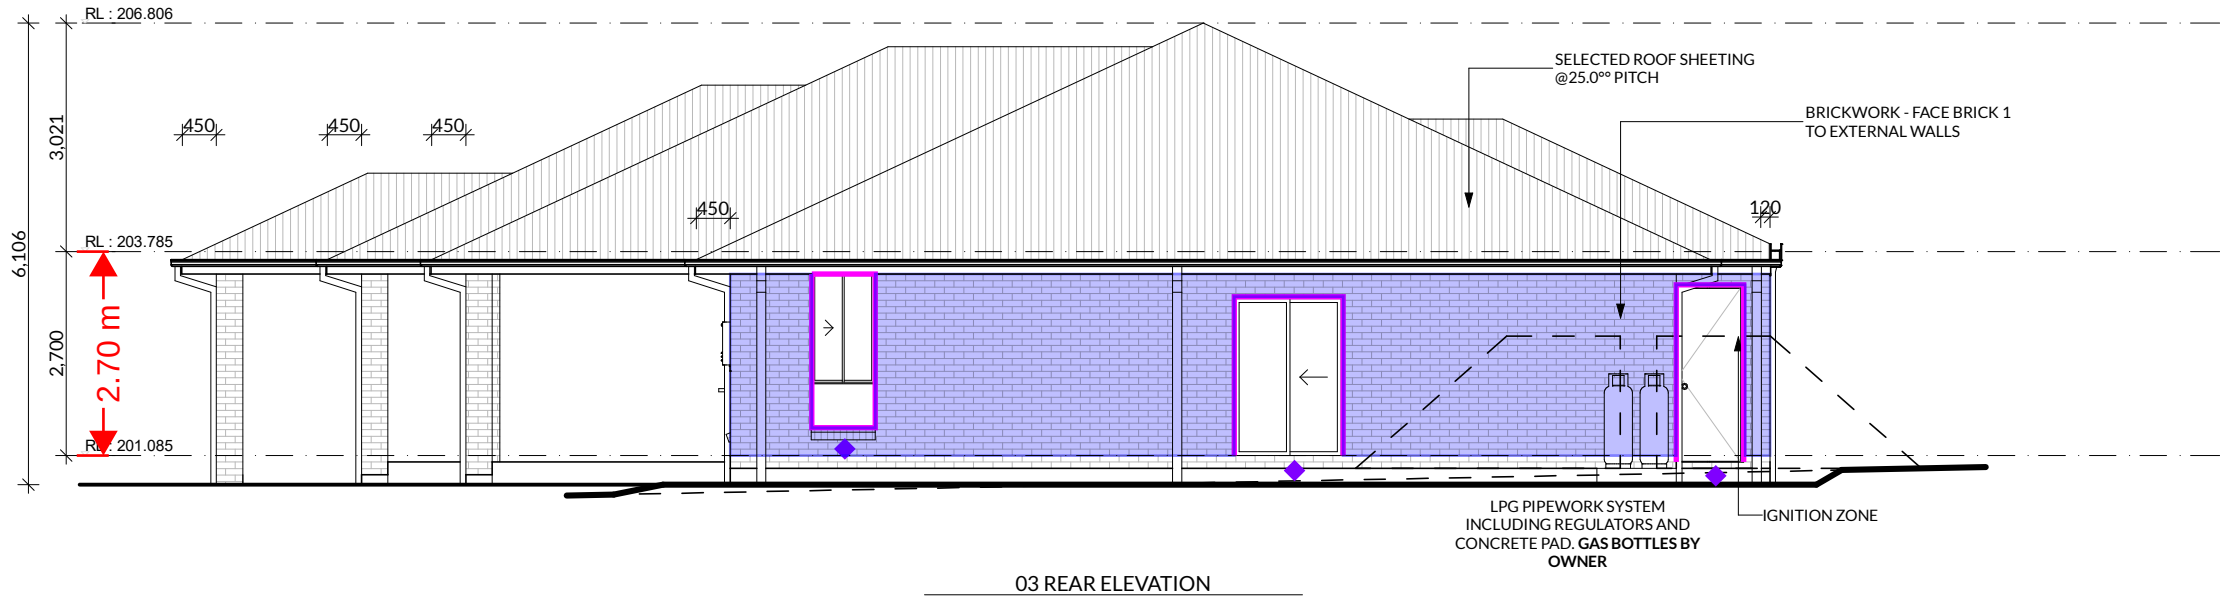

NOTES:

- * REFER TO ENGINEERS DETAILS FOR ALL EXPANSION JOINT LOCATIONS.
- * REFER TO ENGINEERS DETAILS FOR ALL STEEL BEAM AND FLOOR JOIST LOCATIONS AND DIRECTIONS.
- * REFER TO TRUSS MANUFACTURERS DETAILS FOR ALL FLOOR JOIST SIZES AND DIRECTIONS.
- * REFER TO A/C DETAILS FOR A/C DUCT POSITIONS.
- * A/C DUCT LOCATIONS MAY NEED TO CHANGE DUE TO CONSTRUCTION REQUIREMENTS (JOIST LOCATION, STRUCTURAL BEAMS ETC).
- * FLOOR FINISHES AS SELECTED AS PER TENDER.
- * STAIRS TO MEET THE MINIMUM SLIP RESISTANCE REQUIREMENT OF PART 11.2.4 OF NCC 2022 WHEN TESTED IN ACCORDANCE WITH AS4586-2013
- * FLOOR COVERINGS WILL ACHIEVE A MINIMUM SLIP RESISTANCE CLASSIFICATION OF P4 IN ACCORDANCE WITH AS4586 AND NCC 2022
- * FIRST FLOOR WINDOWS TO BE RESTRICTED TO OPEN A MAX. OF 125mm IF SILL HEIGHT IS LOWER THAN 1700mm ABOVE A FLOOR LEVEL.
- * HANDRAILS TO STAIRS IN ACCORDANCE WITH NCC 2022 PART 11.3.5
- * NOTES: BOUNDARY SETBACKS MUST BE VERIFIED BY A REGISTERED SURVEYOR BEFORE COMMENCEMENT OF ANY BUILDING WORK. LEVELS SHOWN ARE BASED ON CONTOUR SURVEY PREPARED BY A REGISTERED SURVEYOR
- * ALL WORK TO BE CARRIED OUT IN ACCORDANCE WITH THESE DRAWINGS, COUNCIL REQUIREMENTS, RELEVANT CODES & STANDARDS. DRAWINGS ARE TO BE READ IN CONJUNCTION WITH SPECIFICATIONS PROVIDED.
- * ENGINEERS DETAILS, WHERE ENGINEERS STRUCTURAL DRAWINGS ARE REQUIRED THE ENGINEERS PLAN WILL TAKE PREFERENCE TO THESE DRAWINGS. IN THE EVENT OF ANY ALTERATIONS OR DISCREPANCIES, NOTIFY THE BUILDER IMMEDIATELY. FIGURED DIMENSIONS TO BE READ IN PREFERENCE TO SCALING & TO BE CHECKED & VERIFIED BEFORE WORK IS COMMENCED.
- * ALL SMOKE ALARMS TO BE IN ACCORDANCE WITH PART 9.5 OF NCC 2022
- * THESE PLANS ARE NOT WORKSHOP DETAILED DRAWINGS AND THEY DO NOT SHOW ALL ELEMENTS, FIXTURES, FITTINGS AND DETAIL AS THEY WILL APPEAR ON SITE ONCE BUILT. THERE WILL BE FIXTURES AND FITTINGS FOR MATERIALS USED ON SITE THAT WILL BE VISIBLE AND FORM PART OF THE HOME BUILT THAT CAN'T BE SHOWN ON THESE ARCHITECTURAL PLANS



REVISION SCHEDULE		
ISSUE	DATE	DESCRIPTION
A	4.7.25	CC/DA ISSUE
B	1.9.25	CR-02
C	10.09.25	CR-03
D	29.09.25	BAL NOTES
E	8.10.25	LPOD NOTE ADDED
-	-	-